

410 North Street
Floor Plans

Scott Goodwin (Owner)
802-922-6336
410 North St.
Burlington, VT 05401

Permit Set
Revised 3/14/17

First Floor

- Living Room = 180 sf
- Kitchen = 270 sf
- Bathroom = 76.5 sf
- Bedroom 1 = 175.5 sf
- Hallway 1 = 78 sf
- Dining Room = 165.75 sf
- Vestibule = 24 sf
- Total = 969.75 sf

Second Floor

- Hallway = 45 sf
- Bedroom 2 = 205.25 sf
- Bedroom 3 = 194.5 sf
- Stairs and Closet = 52.5 sf
- Total = 497.25 sf

House Total = 1467 sf

Room Area
Chart

A-3



Date:
3/14/17

Scale:
1/4"=1'

410 North Street
Floor Plans

Scott Goodwin (Owner)
802-922-6336
410 North St.
Burlington, VT 05401

Permit Set
Revised 3/14/17

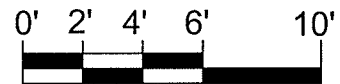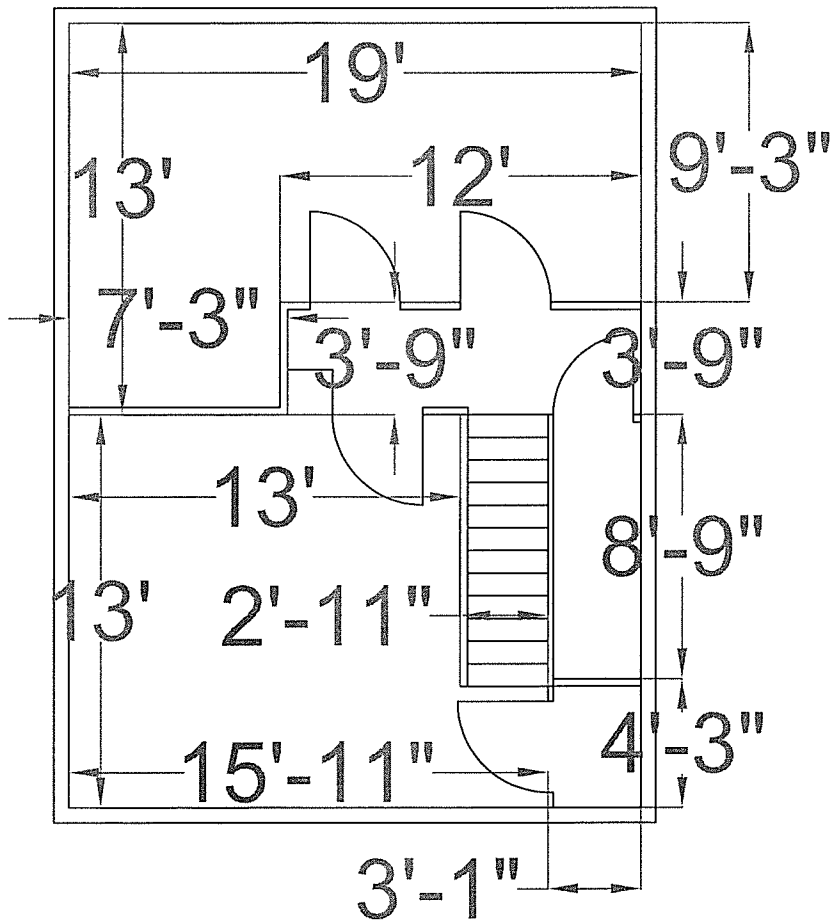


Architectural
Plan Floor 2

A-2

Date:
3/14/17


Scale:
1/4"=1'

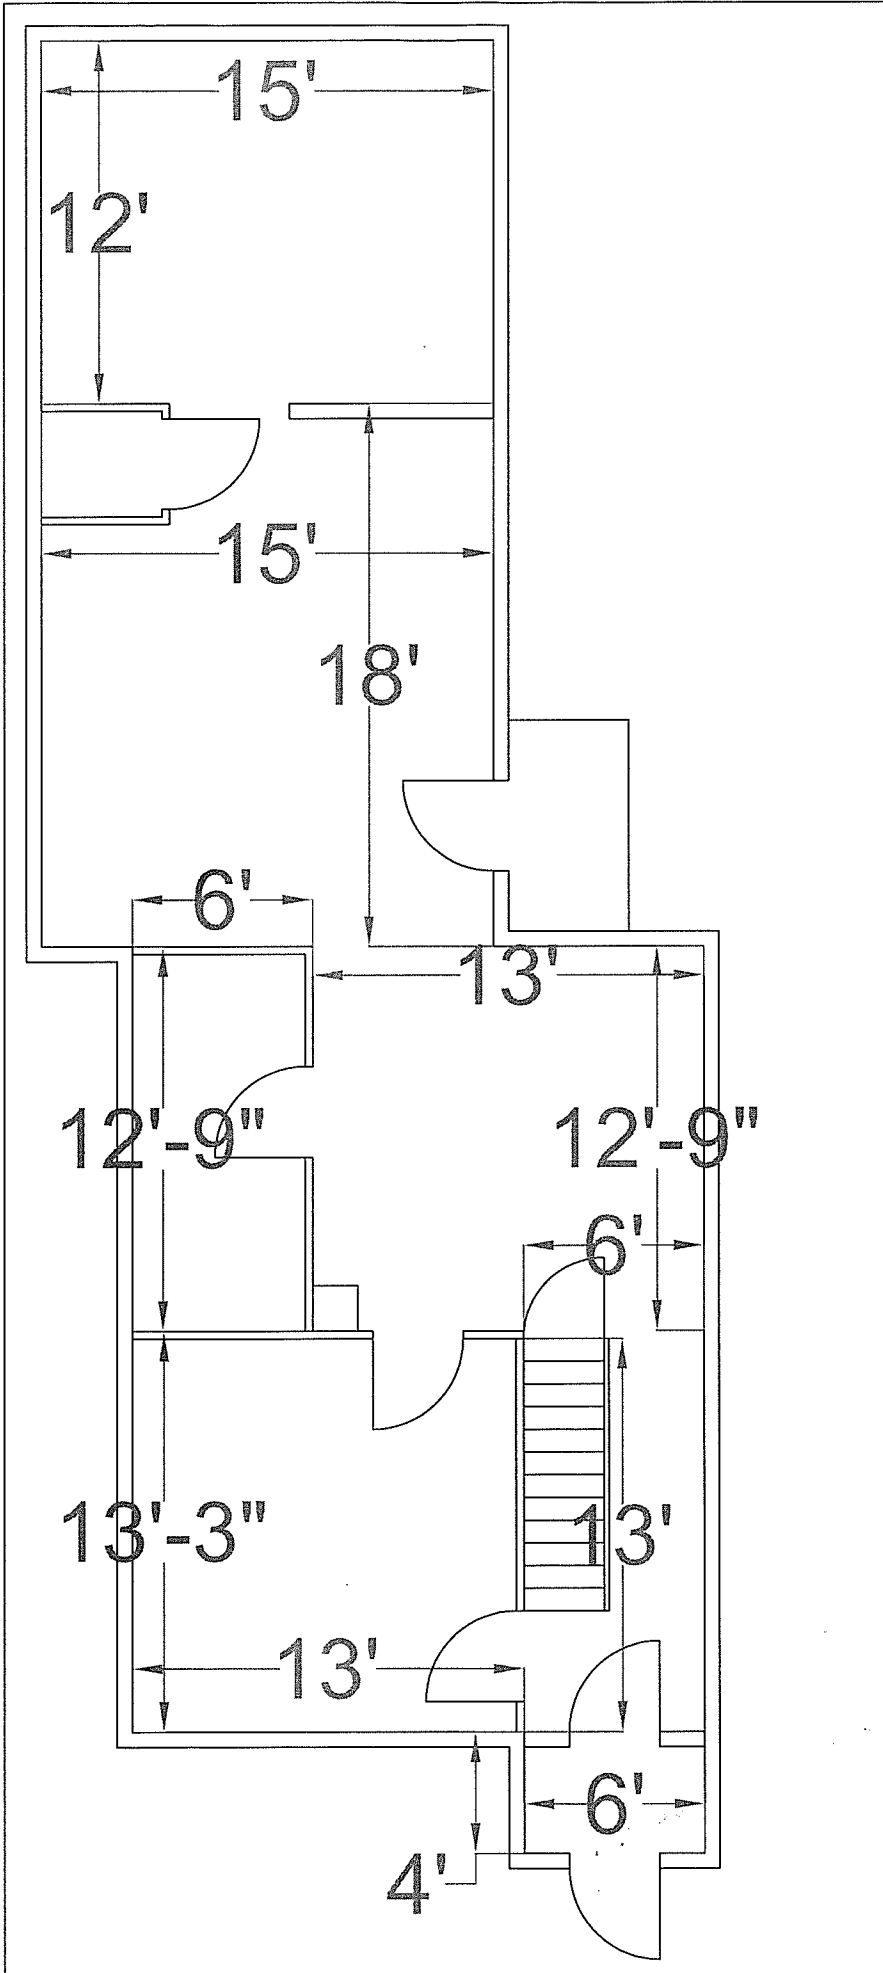

410 North Street
Floor Plans

Scott Goodwin (Owner)
802-922-6336
410 North St.
Burlington, VT 05401

Permit Set
Revised 3/14/17

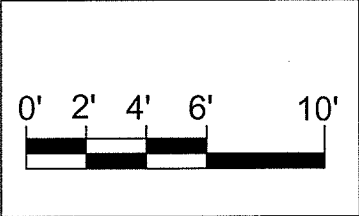

Architectural
Plan Floor 2

A-2

Date:
3/14/17

Scale:
1/4"=1'


410 North Street
Garage Addition
Renovations

Scott Goodwin (Owner)
802-922-6336
410 North St.
Burlington, VT 05401

Permit Set
Revised 2/10/17

RECEIVED
FEB 16 2017
DEPARTMENT OF
PLANNING & ZONING

Main Dwelling Finished Area = ~~1438~~¹⁴⁶⁷-sf
Accessory Finished Area = 610 sf
Total Finished Area = ~~2048~~²⁰⁷⁷
Percent = ~~29.8%~~^{29.4%}

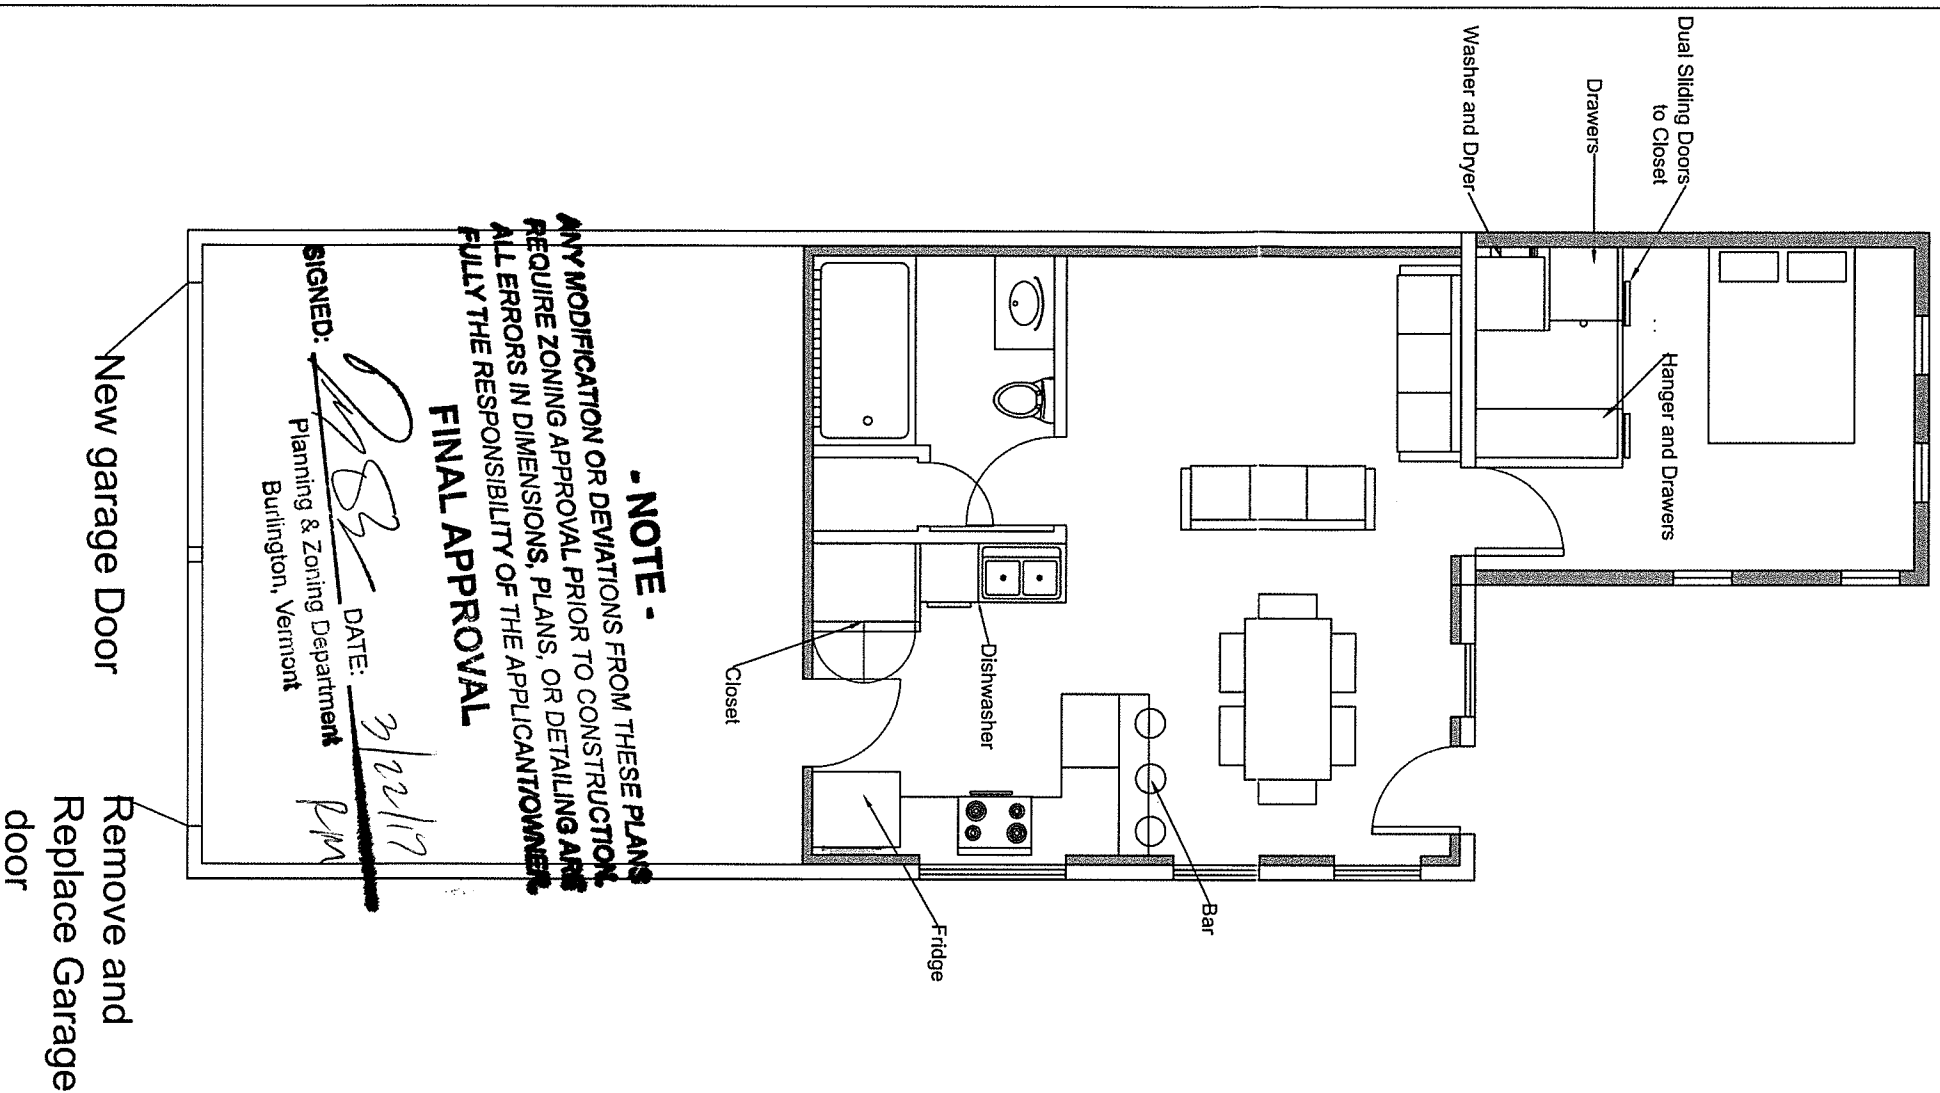


Architectural
Plan



A-1

Date: 2/10/17 Scale: 3/16"=1'

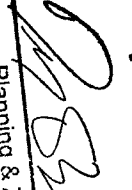SIGNED:  DATE: 3/22/17
Planning & Zoning Department
Burlington, Vermont *pm*


MAI REPTI UNTE DE UNVENS CO NOTIACIOM MA
NOTIACIOM MAI UNTE UNVENS CO NOTIACIOM MA
MAI UNTE UNVENS CO NOTIACIOM MA
NOTIACIOM MAI UNTE UNVENS CO NOTIACIOM MA

MAI UNTE UNVENS CO NOTIACIOM MA
NOTIACIOM MAI UNTE UNVENS CO NOTIACIOM MA

Existing Lot Coverage
Impervious/ lot coverage = 2878.5sf
Total Area = 9964.4
Percent Impervious = 28.8%

Proposed Lot Coverage
Impervious/ lot coverage = 3390.3sf
Total Area = 9964.4
Percent Impervious = 34%

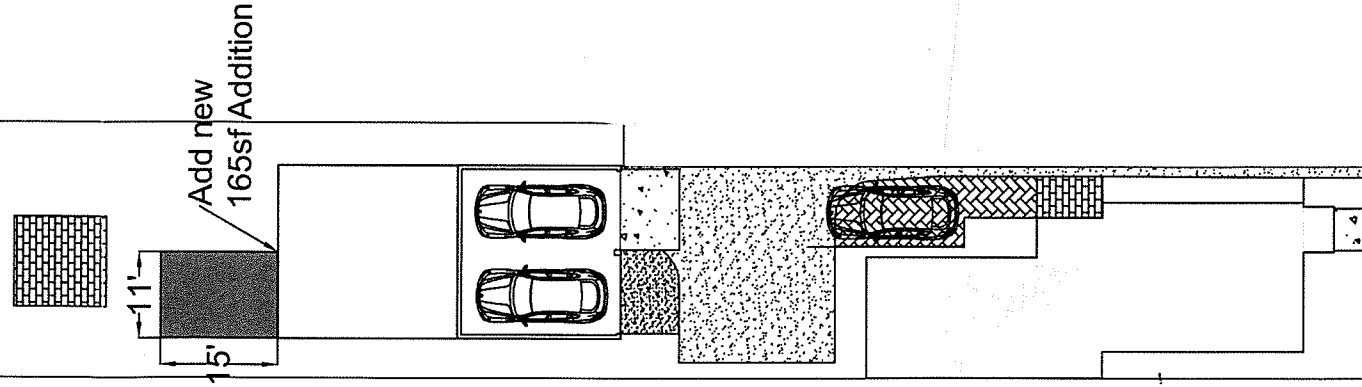

410 North Street
Garage Addition
Renovations

Scott Goodwin (Owner)
802-922-6336
410 North St.
Burlington, VT 05401

Permit Set
Revised 2/10/17

RECEIVED

FEB 16 2017

DEPARTMENT OF
PLANNING & ZONING



Proposed Site
Plan

SP-1

Date:
2/10/17

Scale:
1/2"=10'